

Date: Tuesday, 2/7/2006 12:13:07 PM
 User: Linda Lacelle

Process Sheet

Customer : CU-DAR001 Dart Helicopters Services	Drawing Name : WEARPLATE
Job Number : 25726	
Estimate Number : 10747	
P.O. Number : N/A	Part Number : D33153
This Issue : 2/7/2006 S.O. No. : N/A	Drawing Number : D3315 REV. PRELIM.
Prsht Rev. : NC	Project Number : N/A
First Issue : N/A Type : PURCHASED PARTS	Drawing Revision : A-B 06.03.02 PH
Previous Run : 24607	Material : N/A
Written By : SEE COMMENT BELOW	Due Date : 2/14/2006 Qty: 5/10 Um: Each
Checked & Approved By : <u>W</u>	
Comment : Est: A 05.05.12 New issue KJ/JLM	

Additional Product

Job Number:



Seq. #:	Machine Or Operation:	Description :
----------------	------------------------------	----------------------

1.0	PG	PURCHASING
-----	----	------------

**Comment:** PURCHASING

Issue P/O: 00000521 SP 06/02/06
 Email or Ship DXF file to vendor
 Laser Cut flat pattern per Dwg D3315
 Possible Supplier: Industrial Laser
 Material release note is required

2.0	D33153F	Wearplate, LH Center
-----	---------	----------------------



Comment: Qty.: 1.0000 U(s)/Unit Total: 10.0000 U(s)
 WEARPLATE

3.0	PACKAGING 1	PACKAGING RESOURCE #1
-----	-------------	-----------------------

**Comment:** PACKAGING RESOURCE #1

Recieve & Inspect for Transit Damage
 Ensure Material Release Note is attached

C206102123 (5)

4.0	QC6	DIMENSIONAL CHECK
-----	-----	-------------------

**Comment:** DIMENSIONAL CHECK

Inspect dimensions as per inspection template D3315-3T1

PH 06.03.02 (5)

5.0	SMALL FAB 1	SMALL & MEDIUM FAB RESOURCE 1
-----	-------------	-------------------------------

**Comment:** SMALL & MEDIUM FAB RESOURCE 1

Deburr if necessary

PH 06.03.02 (5)

W/O:		WORK ORDER CHANGES					
DATE	STEP	PROCEDURE CHANGE	By	Date	Qty	Approval Chief Eng / Prod Mgr	Approval QC Inspector

Part No: _____ PAR #: _____ Fault Category: _____ NCR: Yes No DQA: _____ Date: _____

QA: N/C Closed: _____ Date: _____

NCR:		WORK ORDER NON-CONFORMANCE (NCR)						
DATE	STEP	Description of NC Section A	Corrective Action Section B			Verification Section C	Approval Chief Eng	Approval QC Inspector
			Initial Chief Eng	Action Description Chief Eng	Sign & Date			

NOTE: Date & initial all entries

Date: Tuesday, 2/7/2006 12:13:07 PM
User: Linda Lacelle

Process Sheet

Customer: CU-DAR001 Dart Helicopters Services

Drawing Name: WEARPLATE

Job Number: 25726

Part Number: D33153

Job Number:



Seq. #:

Machine Or Operation:

Description :

6.0

BRAKE NC

NC BRAKE



Comment: NC BRAKE

1- Form using DT8179 Die and DT8157 as per Dwg D3315 Rev: B

B 06.03.08 (5)

7.0

QC6

DIMENSIONAL CHECK



Comment: DIMENSIONAL CHECK

06.03.09

8.0

LARGE FAB 1

LARGE FABRICATION RESOURCE 1



Comment: LARGE FABRICATION RESOURCE 1

Weld hard surface using D3315-3T3 as per QSI 004 and Dwg D3315 Rev: B

Qty Part Number Description Batch

A/R N/A 7560 Hardcoat Rod

M19682

CPC 06.03.15

(5) PTO

9.0

QC9

VISUAL WELDING INSPECTION



Comment: VISUAL WELDING INSPECTION

12/06/03/16

(4)

10.0

POWDER COATING

POWDER COATING



Comment: POWDER COATING

Powder Coat Grey Sandtex (Ref: 4.3.5.6) as per QSI 005 4.3

DL 06/03/20

(4)

11.0

QC3

INSPECT POWDER COAT/CHEMICAL CONVERSION



Comment: INSPECT POWDER COAT

ml 06 03 21

(4)

12.0

PACKAGING 1

PACKAGING RESOURCE #1



Comment: PACKAGING RESOURCE #1

Identify on inside surface using a permanent fine point marker with the following:

TCCA-PDA, Dart Aerospace Ltd.

P/N: D3315-3, B/N: BXXXXX

For Product Eligibility see PDA04-17

and Stock

Location: _____

PDA05-17 PH 05.03.09

P-9/3/21 (4)

Dart Aerospace Ltd

W/O:		WORK ORDER CHANGES					
DATE	STEP	PROCEDURE CHANGE	By	Date	Qty	Approval Chief Eng / Prod Mgr	Approval QC Inspector
06-03-14	8	Took 1x D3315-3 wear plate to make D3315-3T3 welding template Inspected by: <i>[Signature]</i> 06-03-14	<i>[Signature]</i>	06-03-14	1	<i>[Signature]</i>	<i>[Signature]</i> 06-03-14

Part No: _____ PAR #: _____ Fault Category: _____ NCR: Yes ☒ No ☐ DQA: *[Signature]* Date: 06/03/22
 QA: N/C Closed: _____ Date: _____

NCR:		WORK ORDER NON-CONFORMANCE (NCR)						
DATE	STEP	Description of NC Section A	Corrective Action Section B			Verification Section C	Approval Chief Eng	Approval QC Inspector
			Initial Chief Eng	Action Description Chief Eng	Sign & Date			

NOTE: Date & initial all entries

Date: Tuesday, 2/7/2006 12:13:07 PM
User: Linda Lacelle

Process Sheet

Customer: CU-DAR001 Dart Helicopters Services

Drawing Name: WEARPLATE

Job Number: 25726

Part Number: D33153

Job Number:



Seq. #:

Machine Or Operation:

Description :

13.0

DC

DOCUMENT CONTROL



Comment: DOCUMENT CONTROL
Inspection Level 21

④
06/03/22

Job Completion



u 06/03/22

W/O:		WORK ORDER CHANGES					
DATE	STEP	PROCEDURE CHANGE	By	Date	Qty	Approval Chief Eng / Prod Mgr	Approval QC Inspector

Part No: _____ PAR #: _____ Fault Category: _____ NCR: Yes No DQA: _____ Date: _____

QA: N/C Closed: _____ Date: _____

NCR:		WORK ORDER NON-CONFORMANCE (NCR)						
DATE	STEP	Description of NC Section A	Corrective Action Section B			Verification Section C	Approval Chief Eng	Approval QC Inspector
			Initial Chief Eng	Action Description Chief Eng	Sign & Date			

NOTE: Date & initial all entries



New Zealand Steel Limited
Glenbrook, South Auckland
Postal: Private Bag 92121, Auckland, New Zealand
Telephones: (09) 375 8999 / 375 8111 Auckland
(09) 235 8089 / 235 3535 Waiuku
Fax: (09) 375 8959

TEST CERTIFICATE

Ref: 559724541

CUSTOMER	Willason	P50707DI002	SPECIFICATION	ASTMA1008 CS Type A	CERTIFICATE No	TC120140																		
CUSTOMER O/N	90-21N-830		PRODUCT	CRA WIDE COIL	PAGE	1 of 1																		
MILL O/N	497550		DIMENSIONS	0.044" x 48" x Coil	DATE	17 October 2005																		
PACK NUMBER	HEAT No	CHEMICAL COMPOSITION PERCENT													MECHANICAL TESTS (TEST SPECIFICATION - ASTMA370)									
		C	Si	Mn	P	S	Cu	Ni	Cr	Mo	V	Nb	Ti	Al	B	N2	CE ()	BEND	YIELD	T.S.	%ELONG	HARDNESS	r	LENGTH
		x100			x1000							x10000		x100		180°				G.L.=	HRB	()	(feet)	
R9-467017-00	644043	5	TR	20	14	17	12	17	29	1	8	1	1					Good				52		1965
R9-467018-00	644043	5	TR	20	14	17	12	17	29	1	8	1	1					Good				52		1939
R9-467896-00	644286	5	TR	20	12	16	12	17	24	5	5	1	1					Good				49		2031
R9-467897-00	644286	5	TR	20	12	16	12	17	24	5	5	1	1					Good				49		1932
R9-467898-00	644286	5	TR	20	12	16	12	17	24	5	5	1	1					Good				58		2031
R9-467899-00	644286	5	TR	20	12	16	12	17	24	5	5	1	1					Good				50		1808
R9-468376-00	644291	5	TR	18	8	20	14	16	18	1	5	1	1					Good				45		1978
R9-468377-00	644291	5	TR	18	8	20	14	16	18	1	5	1	1					Good				45		1955

P.0521

YIELD	GAUGE LENGTH (G.L.)	PLASTIC STRAIN RATIO (r)	IMPACT TEST	(C)=5mm x 5mm	CARBON EQUIVALENT VALUE (CE)
(A)=0.2% PROOF STRESS	(A)=200mm (C)=80mm (E)=2"	(A)=r0 (C)=r45	(A)=10mm x 10mm	(D)=2.5mm x 10mm	(A)=C+Mn/6
(B)=LOWER YIELD STRESS	(B)=50mm (D)=5.65% So (F)=8"	(B)=r90 (D)=(r0+r90+2r45)/4	(B)=7.5mm x 10mm	(E)=5mm x 10mm	(B)=C+Mn/6+(Cr+V+Mo)/5+(Cu+Ni)/15
					(C)=C+Mn/6+Si/24
					(D)=

WE HEREBY CERTIFY THAT THE MATERIAL DESCRIBED HEREIN HAS BEEN TESTED AND INSPECTED
WITH SATISFACTORY RESULTS IN ACCORDANCE WITH THE REQUIREMENTS OF THE ABOVE SPECIFICATION

APPROVED *Satish Misra*
QC METALLURGIST



New Zealand Steel Limited
Glenbrook, South Auckland
Postal: Private Bag 92121, Auckland, New Zealand
Telephones: (09) 375 8999 / 375 8111 Auckland
(09) 235 8089 / 235 3535 Waiuku
Fax: (09) 375 8999

TEST CERTIFICATE

Ref: 5746/25194

Reissued 1/12/2005

STEEL

REVISION 17/2/2005

CUSTOMER	Wilkinson	P50916D1001	SPECIFICATION	ASTMA1008 CS Type A	CERTIFICATE No	TC122435																				
CUSTOMER O/N	90-21N-963		PRODUCT	CRA WIDE COIL	PAGE	1 of 1																				
MILL O/N	507683		DIMENSIONS	0.114" x 48" x Coil	DATE	29 November 2005																				
PACK NUMBER	HEAT No	CHEMICAL COMPOSITION PERCENT															MECHANICAL TESTS (TEST SPECIFICATION - ASTMA370)									
		C	Si	Mn	P	S	Cu	Ni	Cr	Mo	V	Nb	Ti	Al	B	N2	CE ()	BEND	YIELD	T.S.	%ELONG	HARDNESS	r	LENGTH		
		x100			x1000											x10000		x100	180°				GL =	HRB	()	(feet)
R9-471775-00	644609	4	TR	20	8	11	11	17	23	1	6	1	1					Good				51		794		
R9-471776-00	644609	4	TR	20	8	11	11	17	23	1	6	1	1					Good				51		682		
R9-471777-00	644609	4	TR	20	8	11	11	17	23	1	6	1	1					Good				54		768		
R9-471778-00	644609	4	TR	20	8	11	11	17	23	1	6	1	1					Good				54		640		

YIELD (A)=0.2% PROOF STRESS (B)=LOWER YIELD STRESS	GAUGE LENGTH (G.L.) (A)=200mm (C)=80mm (E)=2" (B)=50mm (D)=5.65 So (F)=8"	PLASTIC STRAIN RATIO (r) (A)=r0 (C)=r45 (B)=r90 (D)=(r0+r90+2r45)/4	IMPACT TEST (A)=10mm x 10mm (B)=7.5mm x 10mm (C)=5mm x 5mm (D)=2.5mm x 10mm (E)=5mm x 10mm	CARBON EQUIVALENT VALUE (CE) (A)=C+Mn/6 (B)=C+Mn/6+(Cr+V+Mo)/5+(Cu+Ni)/15 (C)=C+Mn/6+Si/24 (D)=
--	---	---	---	---


WE HEREBY CERTIFY THAT THE MATERIAL DESCRIBED HEREIN HAS BEEN TESTED AND INSPECTED
WITH SATISFACTORY RESULTS IN ACCORDANCE WITH THE REQUIREMENTS OF THE ABOVE SPECIFICATION

APPROVED *Satish Misra*
QC METALLURGIST

60117ND020-1 M INDUSTRIAL (P50916D1001) (9)

PROTOTYPE
PLEASE RETURN ALL ISSUED
DATA TO ENGINEERING
05.01.31


DESIGN	DRAWN BY	DART AEROSPACE LTD
CHECKED	APPROVED	DRAWING NO. D3315
DATE 06.01.31	04.09.10	TITLE WEARPLATE
A	06.01.31	NEW ISSUE
B		UPDATE DIMENSIONS
		SCALE 1:12
		SHEET 1 OF 4
		REV. B

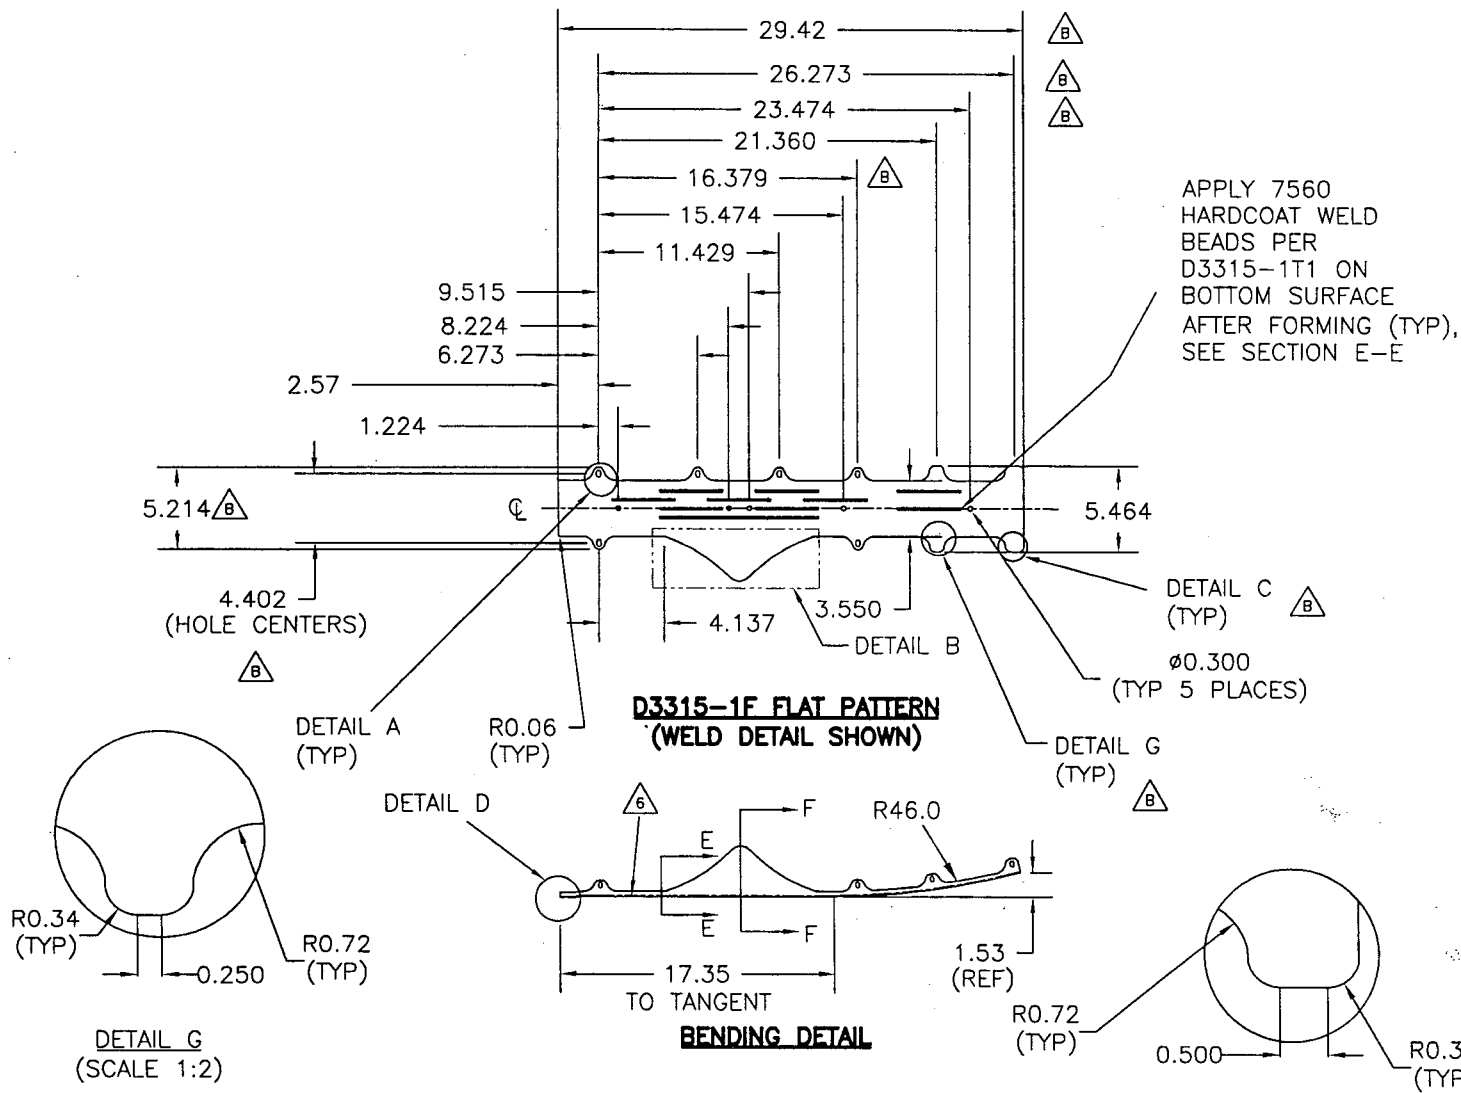

D3315-1 WEARPLATE (SHOWN, -2 OPPOSITE)

- 1) MATERIAL: AISI 1010-1025 OR ASTM A36/A366/A1008 OR CSA G40-21, 38W/44W/50W/60W/70W SERIES STEEL 16 GAUGE (0.060 THICK)
- 2) FINISH: POWDER COAT GREY SANDTEX (REF.4.3.5.6) PER DART QSI 005 4.3
- 3) WELD PER DART QSI 004
- 4) TOLERANCES ARE PER DART QSI 018 UNLESS OTHERWISE NOTED
- 5) ALL DIMENSIONS ARE IN INCHES
- 6) IDENTIFY ON INSIDE SURFACE AS INDICATED USING FINE POINT PERMANENT INK MARKER:
"TCCA-PDA, DART AEROSPACE LTD., P/N D3315-X
B/N BXXXXX, FOR PRODUCT ELIGIBILITY SEE PDA05-17"

PROTOTYPE
PLEASE RETURN ALL ISSUED
DATA TO ENGINEERING
06.03.37

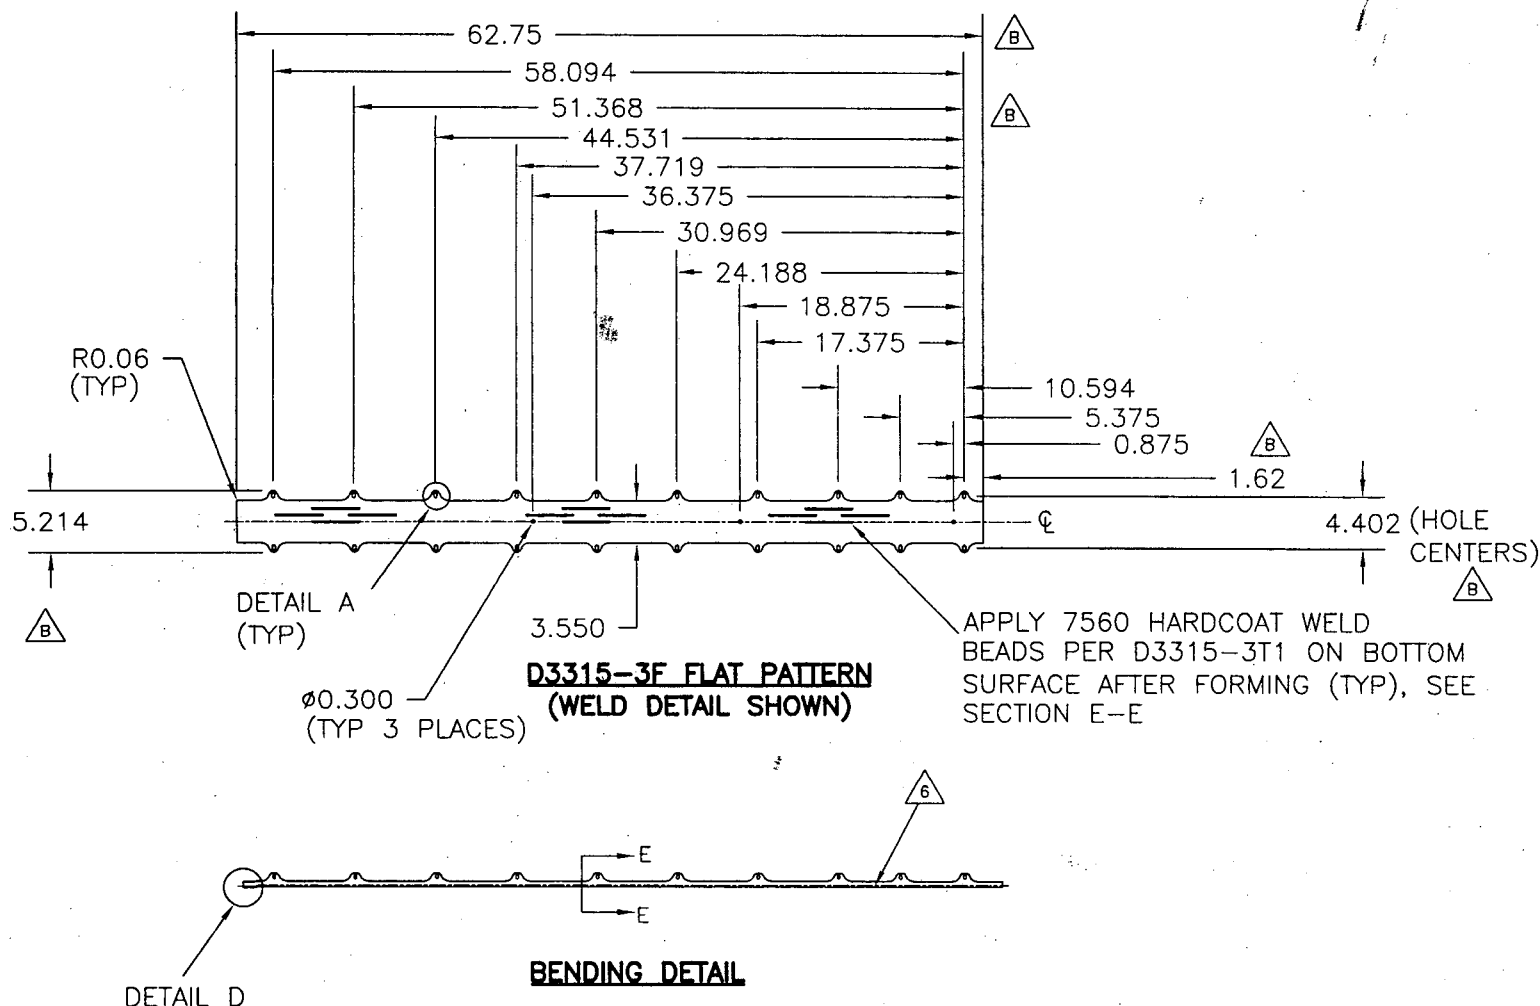


D3315-3 WEARPLATE (SHOWN, -4 OPPOSITE)

- 1) MATERIAL: AISI 1010-1025 OR ASTM A36/A366/A1008 OR CSA G40-21, 38W/44W/50W/60W/70W SERIES STEEL 16 GAUGE (0.060 THICK)
- 2) FINISH: POWDER COAT GREY SANDTEX (REF.4.3.5.6) PER DART QSI 005 4.3
- 3) WELD PER DART QSI 004
- 4) TOLERANCES ARE PER DART QSI 018 UNLESS OTHERWISE NOTED
- 5) ALL DIMENSIONS ARE IN INCHES
- 6) IDENTIFY ON INSIDE SURFACE AS INDICATED USING FINE POINT PERMANENT INK MARKER:
"TCCA-PDA, DART AEROSPACE LTD., P/N D3315-X"
B/N BXXXXX, FOR PRODUCT ELIGIBILITY SEE PDA05-17"



DESIGN	DRAWN BY	DART AEROSPACE LTD
CHECKED	APPROVED	HAWKESBURY, ONTARIO, CANADA
DATE	DRAWING NO.	REV. B
06.01.31	D3315	SHEET 2 OF 4
	TITLE	SCALE
	WEARPLATE	1:16

PROTOTYPE
PLEASE RETURN ALL ISSUED
DATA TO ENGINEERING
06.02.37 #1

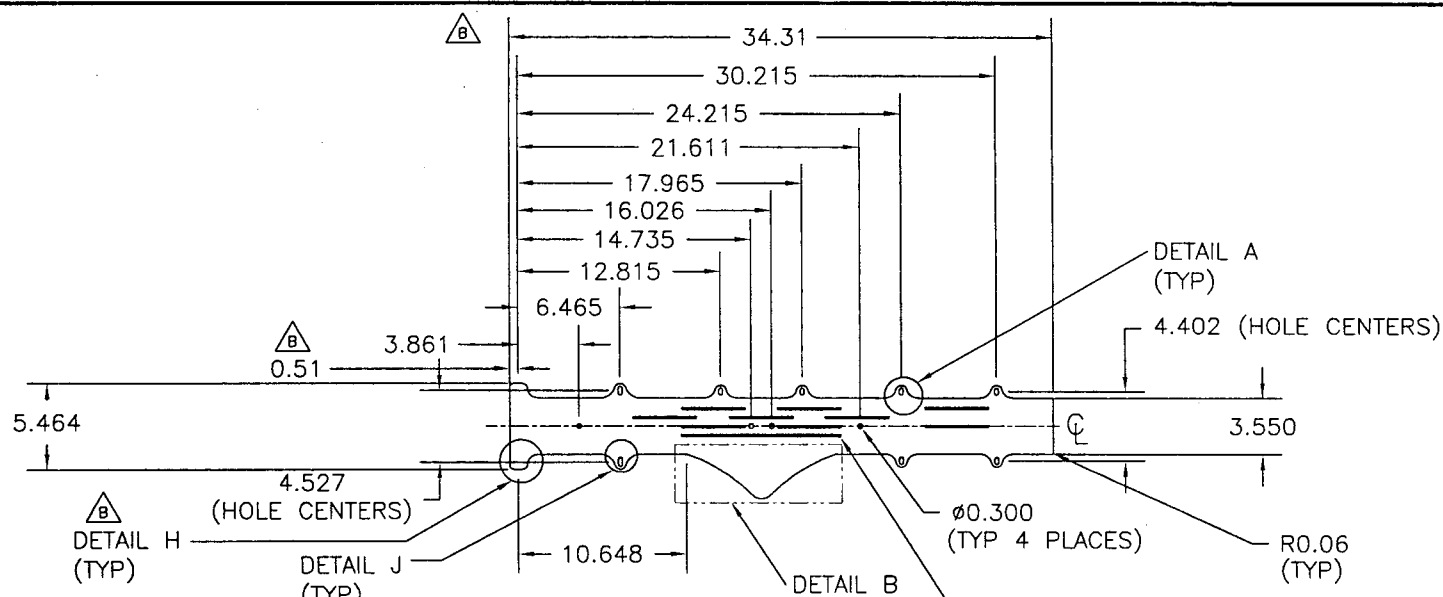


**D3315-5F FLAT PATTERN
(WELD DETAIL SHOWN)**

APPLY 7560 HARDCOAT WELD
BEADS PER D3315-5T1 ON BOTTOM SURFACE
AFTER FORMING (TYP), SEE SECTION E-E

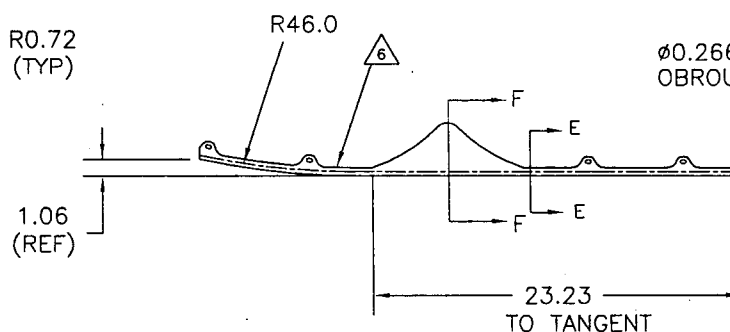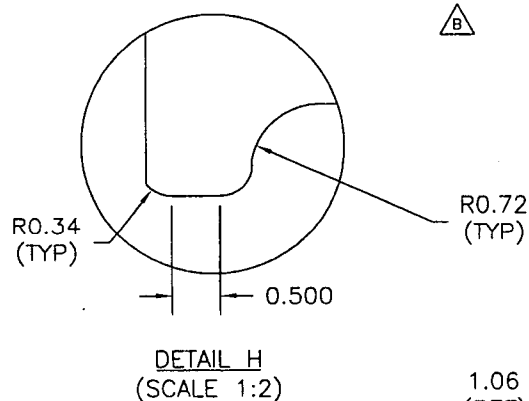

BENDING DETAIL

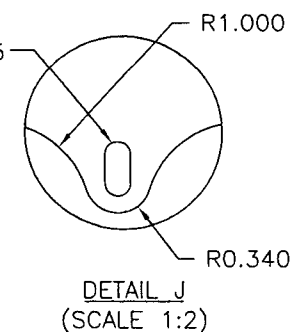

D3315-5 WEARPLATE (SHOWN, -6 OPPOSITE)



- 1) MATERIAL: AISI 1010-1025 OR ASTM A36/A366/A1008 OR CSA G40-21, 38W/44W/50W/60W/70W SERIES STEEL 16 GAUGE (0.060 THICK)
- 2) FINISH: POWDER COAT GREY SANDTEX (REF.4.3.5.6) PER DART QSI 005 4.3
- 3) WELD PER DART QSI 004
- 4) TOLERANCES ARE PER DART QSI 018 UNLESS OTHERWISE NOTED
- 5) ALL DIMENSION ARE IN INCHES
- 6) IDENTIFY ON INSIDE SURFACE AS INDICATED USING FINE POINT PERMANENT INK MARKER:
"TCCA-PDA, DART AEROSPACE LTD., P/N D3315-X
B/N BXXXXX, FOR PRODUCT ELIGIBILITY SEE PDA05-17"

DESIGN	DRAWN BY	DART AEROSPACE LTD HAWKESBURY, ONTARIO, CANADA
CHECKED	APPROVED	DRAWING NO. D3315
DATE 06.01.31	TITLE WEARPLATE	SHEET 3 OF 4
		REV. B SCALE 1:12


PROTOTYPE
PLEASE RETURN ALL ISSUED
DATA TO ENGINEERING
06.02.27 PH

DESIGN	DRAWN BY	DART AEROSPACE LTD HAWKESBURY, ONTARIO, CANADA	
CHECKED	APPROVED	DRAWING NO. D3315	REV. B SHEET 4 OF 4
DATE 06.01.31		TITLE WEARPLATE	SCALE NTS


DETAIL A
(SCALE 1:2)

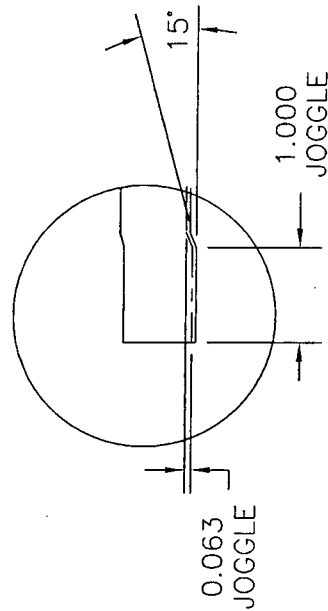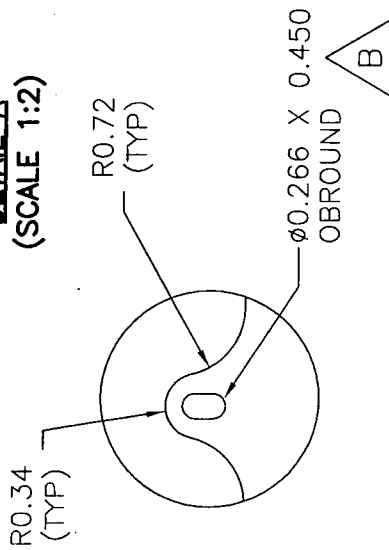


DETAIL D
(SCALE 1:2)

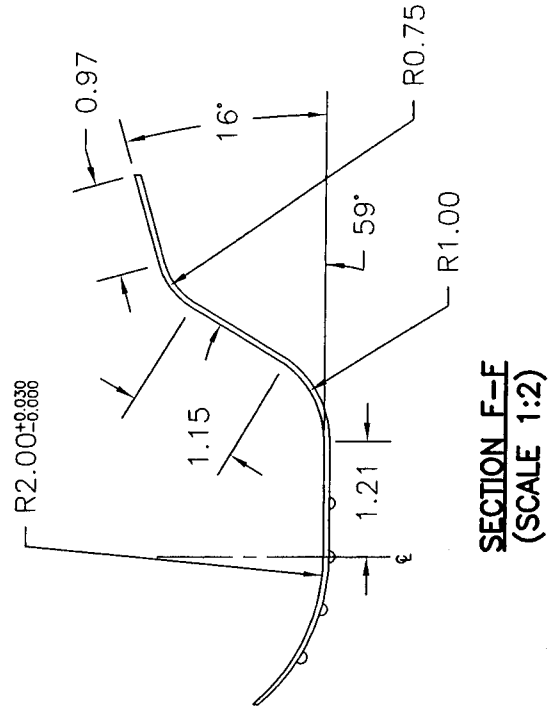

SECTION F-F
(SCALE 1:2)

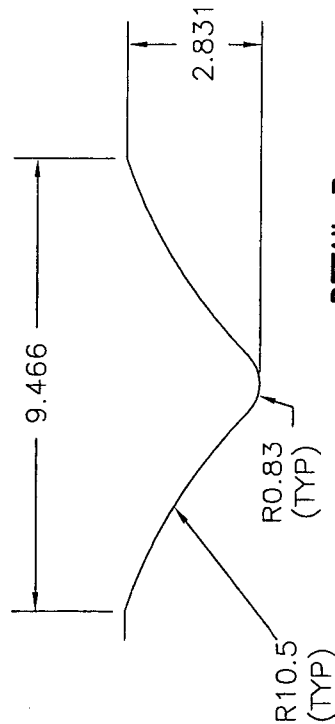

DETAIL B
(SCALE 1:4)

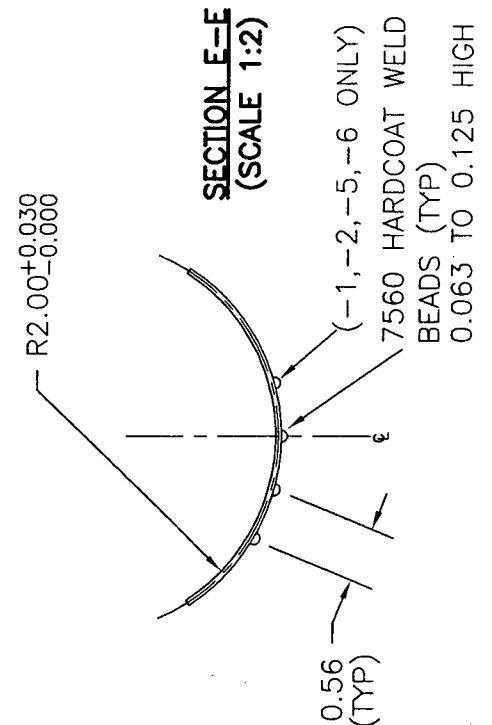

SECTION E-E
(SCALE 1:2)

Copyright © 2005 by DART AEROSPACE LTD

THIS DOCUMENT IS PRIVATE AND CONFIDENTIAL AND IS SUPPLIED ON THE EXPRESS CONDITION THAT IT IS NOT TO BE USED FOR ANY PURPOSE OR COPIED OR COMMUNICATED TO ANY OTHER PERSON WITHOUT WRITTEN PERMISSION FROM DART AEROSPACE LTD.